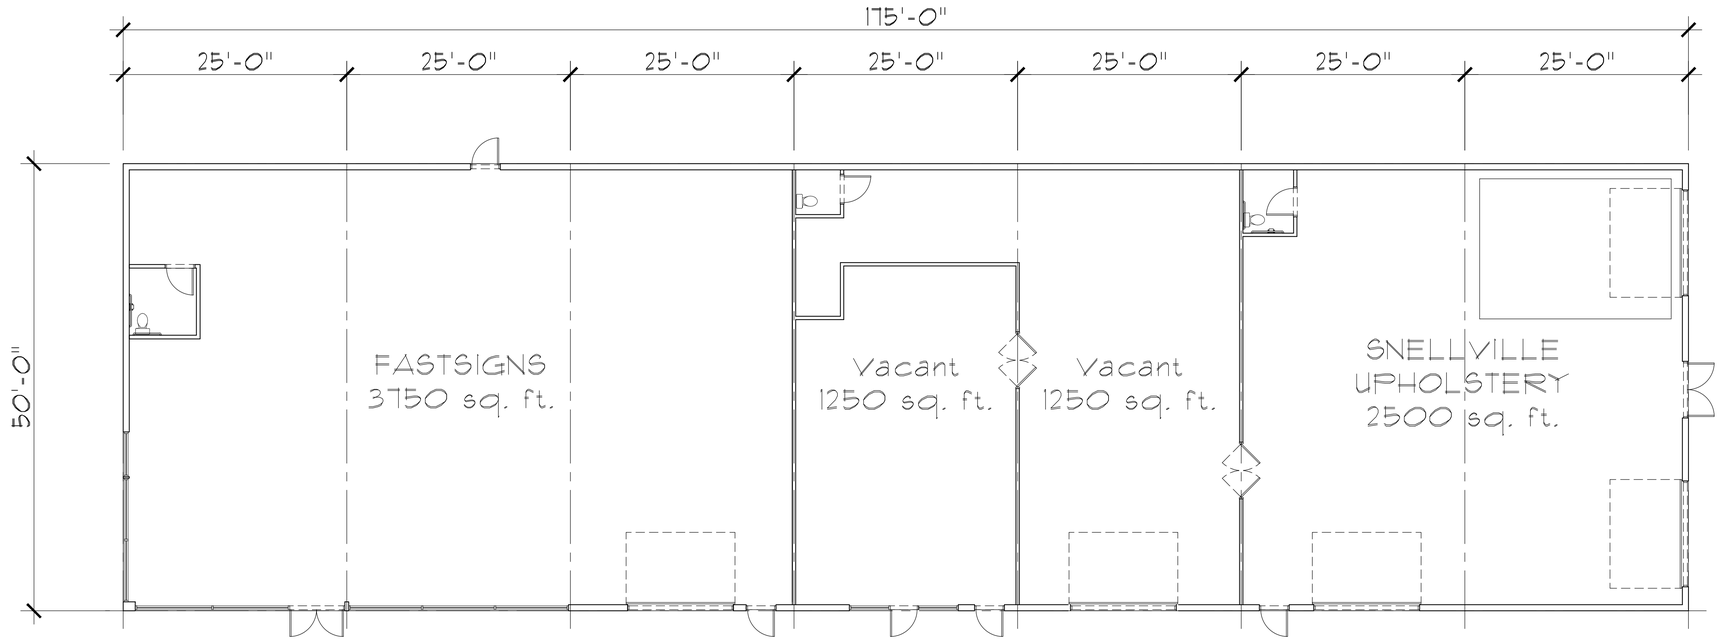

Floor Plan

SCALE: 1/8" = 1'-0"

0 8' 16' 24' 32' 40'

HILLFOLEYROSSI & ASSOCIATES

ARCHITECTURE
ENGINEERING

3680 Pleasant Hill Road
Suite 200
Duluth, Georgia 30096
p 770.622.9858
f 770.622.9535
www.hillfoleyrossi.com

© Copyright (as dated below).
This drawing and all reproductions thereof are the property of Hill Foley Rossi & Associates, LLC, (HFR). It is intended for the sole use of the project named hereon. Reproduction without the written consent of HFR is unlawful. All copies are to be returned to HFR upon project completion.

mk	date	issue

Nov. 22, 2019